


**PLANT LEGEND
BUILDING 1-2-3-4**

SYMBOL	DESCRIPTION	QTY	SIZE
TREES			
(Symbol)	Acer rubrum/Red Sweet Maple	6	2.5" Cal.
(Symbol)	Pinus californica/California Pine	8	2.5" Cal.
(Symbol)	Pinus contorta/Thundercloud Pine	15	2.5" Cal.
(Symbol)	Thuja plicata/Abies/Abies Cedar	17	8-10"
(Symbol)	Acer canadense/Vine Maple	3	5-10"
(Symbol)	Pinus nigra/Austrian Pine	5	8-10"
(Symbol)	Acer rubrum/Red Sweet Maple (street tree)	11	2.5" Cal.

SHRUBS			
(Symbol)	Prunus lauro 'Olio Layken/Olio Layken Laurel	10' ac.	5 Gal. 24" Hr.
(Symbol)	Rhododendron 'Ara Knasche/Ara Knasche Rhododendron	82	5 Gal. 18-24" Hr.
(Symbol)	Pieris japonica/Pieris	70	5 Gal. 18-24" Hr.
(Symbol)	Nandina domestica 'gulf stream/Gulf Stream Nandina	79	5 Gal. 18-24" Hr.
(Symbol)	Viburnum davidsoniae	115	3 Gal. Full
(Symbol)	Berberis thunbergii 'roseglow/Roseglow Barberry	52	2 Gal. 18-24" Hr.
(Symbol)	Photinia fraseri/Photinia	106	5 Gal. 24-30" Hr.
(Symbol)	Linacoba F. 'Rainbow/Rainbow Leucocora	16	5 Gal. Full
(Symbol)	Gaultheria procumbens/Wintergreen	59	1 Gal. Full
(Symbol)	Erica carnea/Heather	125	1 Gal. Full
(Symbol)	Cornus alba/Versigated Reddog Dogwood	33	5 Gal. 18-24" Hr.
(Symbol)	Cornus saskawana/Same	19	5 Gal. 30" Hr.
(Symbol)	Cortaderia Sel. 'Pamela/Ivory Feather/Pamela Grass	16	5 Gal. 36" Hr.
(Symbol)	Phlox paniculata/Flax	8	5 Gal. 24" Hr.
(Symbol)	Thuja occidentalis/Emerald Green Arb.	14	5"
(Symbol)	Prunus lauro 'Shibetsu/Shibetsu Laurel	81	24-30"
(Symbol)	Abelia Grand. 'Ed. (together)/Pink abelia	9	5 Gal. 24-30"
(Symbol)	Thuja occidentalis/Emerald Green Arb.	17	5"
GROUND COVERS			
(Symbol)	Vinca minor/Bowling (18" O.C.) Use as filler	150	1 Gal. Full

GENERAL NOTES:
1. Use Vinca minor as filler when shrub material does not provide sufficient cover


**BUILDINGS 1 & 2
LANDSCAPE PLAN**

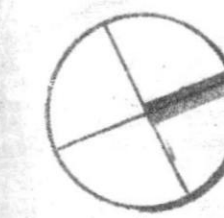

**NORTH
SCALE 1" = 10'**

MATCH LINE SEE SHEET L-2

MATCH LINE SEE SHEET L-2

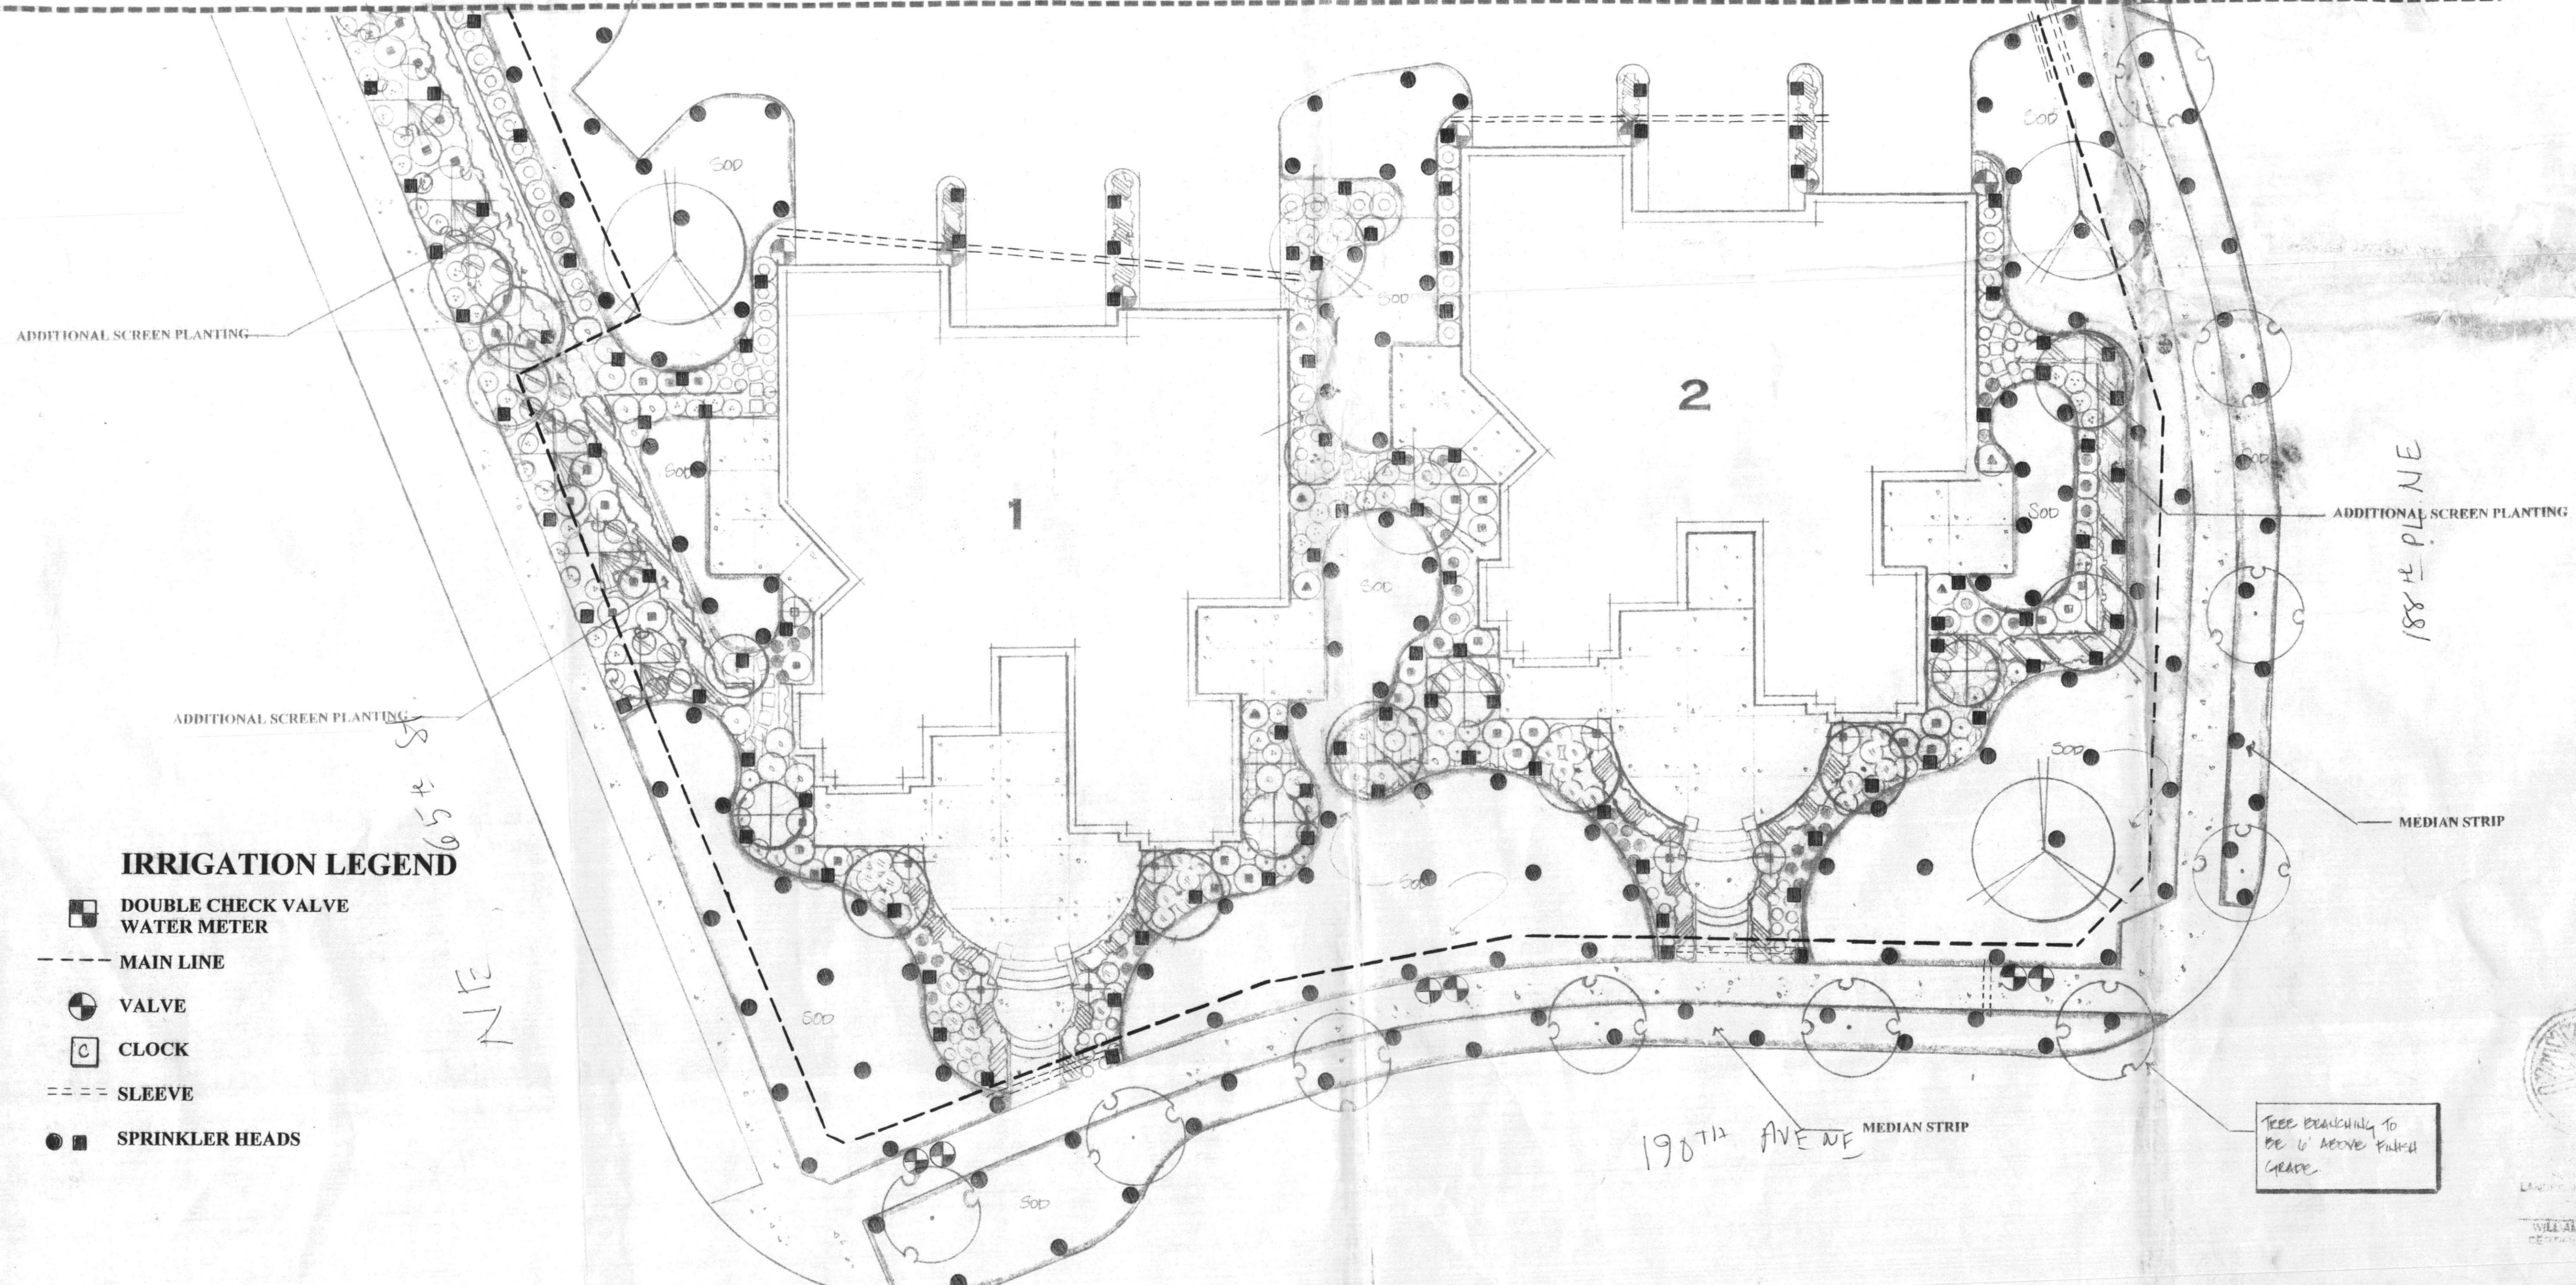

IRRIGATION LEGEND

- DOUBLE CHECK VALVE
- WATER METER
- MAIN LINE
- VALVE
- CLOCK
- SLEEVE
- SPRINKLER HEADS

TREE BRANCHING TO BE 6" ABOVE PAVED GRADE

DRAWN BY: JML
DATE: 10-29-03
CHECKED:
REVISED: 11-07-03

TUTKO Landscaping & Nursery Inc.

CONNER HOMES
REGISTERED
James E. Conner
Landscape Architect
WOODBRIDGE TOWNHOMES


IRRIGATION AS-BUILTS

190th AVE NE MEDIAN STRIP

188th PL N E

WILLIAM...
L-1


BUILDINGS 3 & 4 LANDSCAPE PLAN

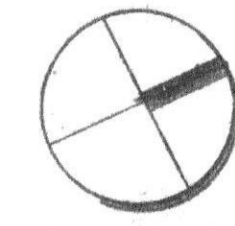

NORTH
SCALE 1" = 10'

GENERAL NOTES:

1. Use Vinca minor as filler when shrub material does not provide sufficient cover

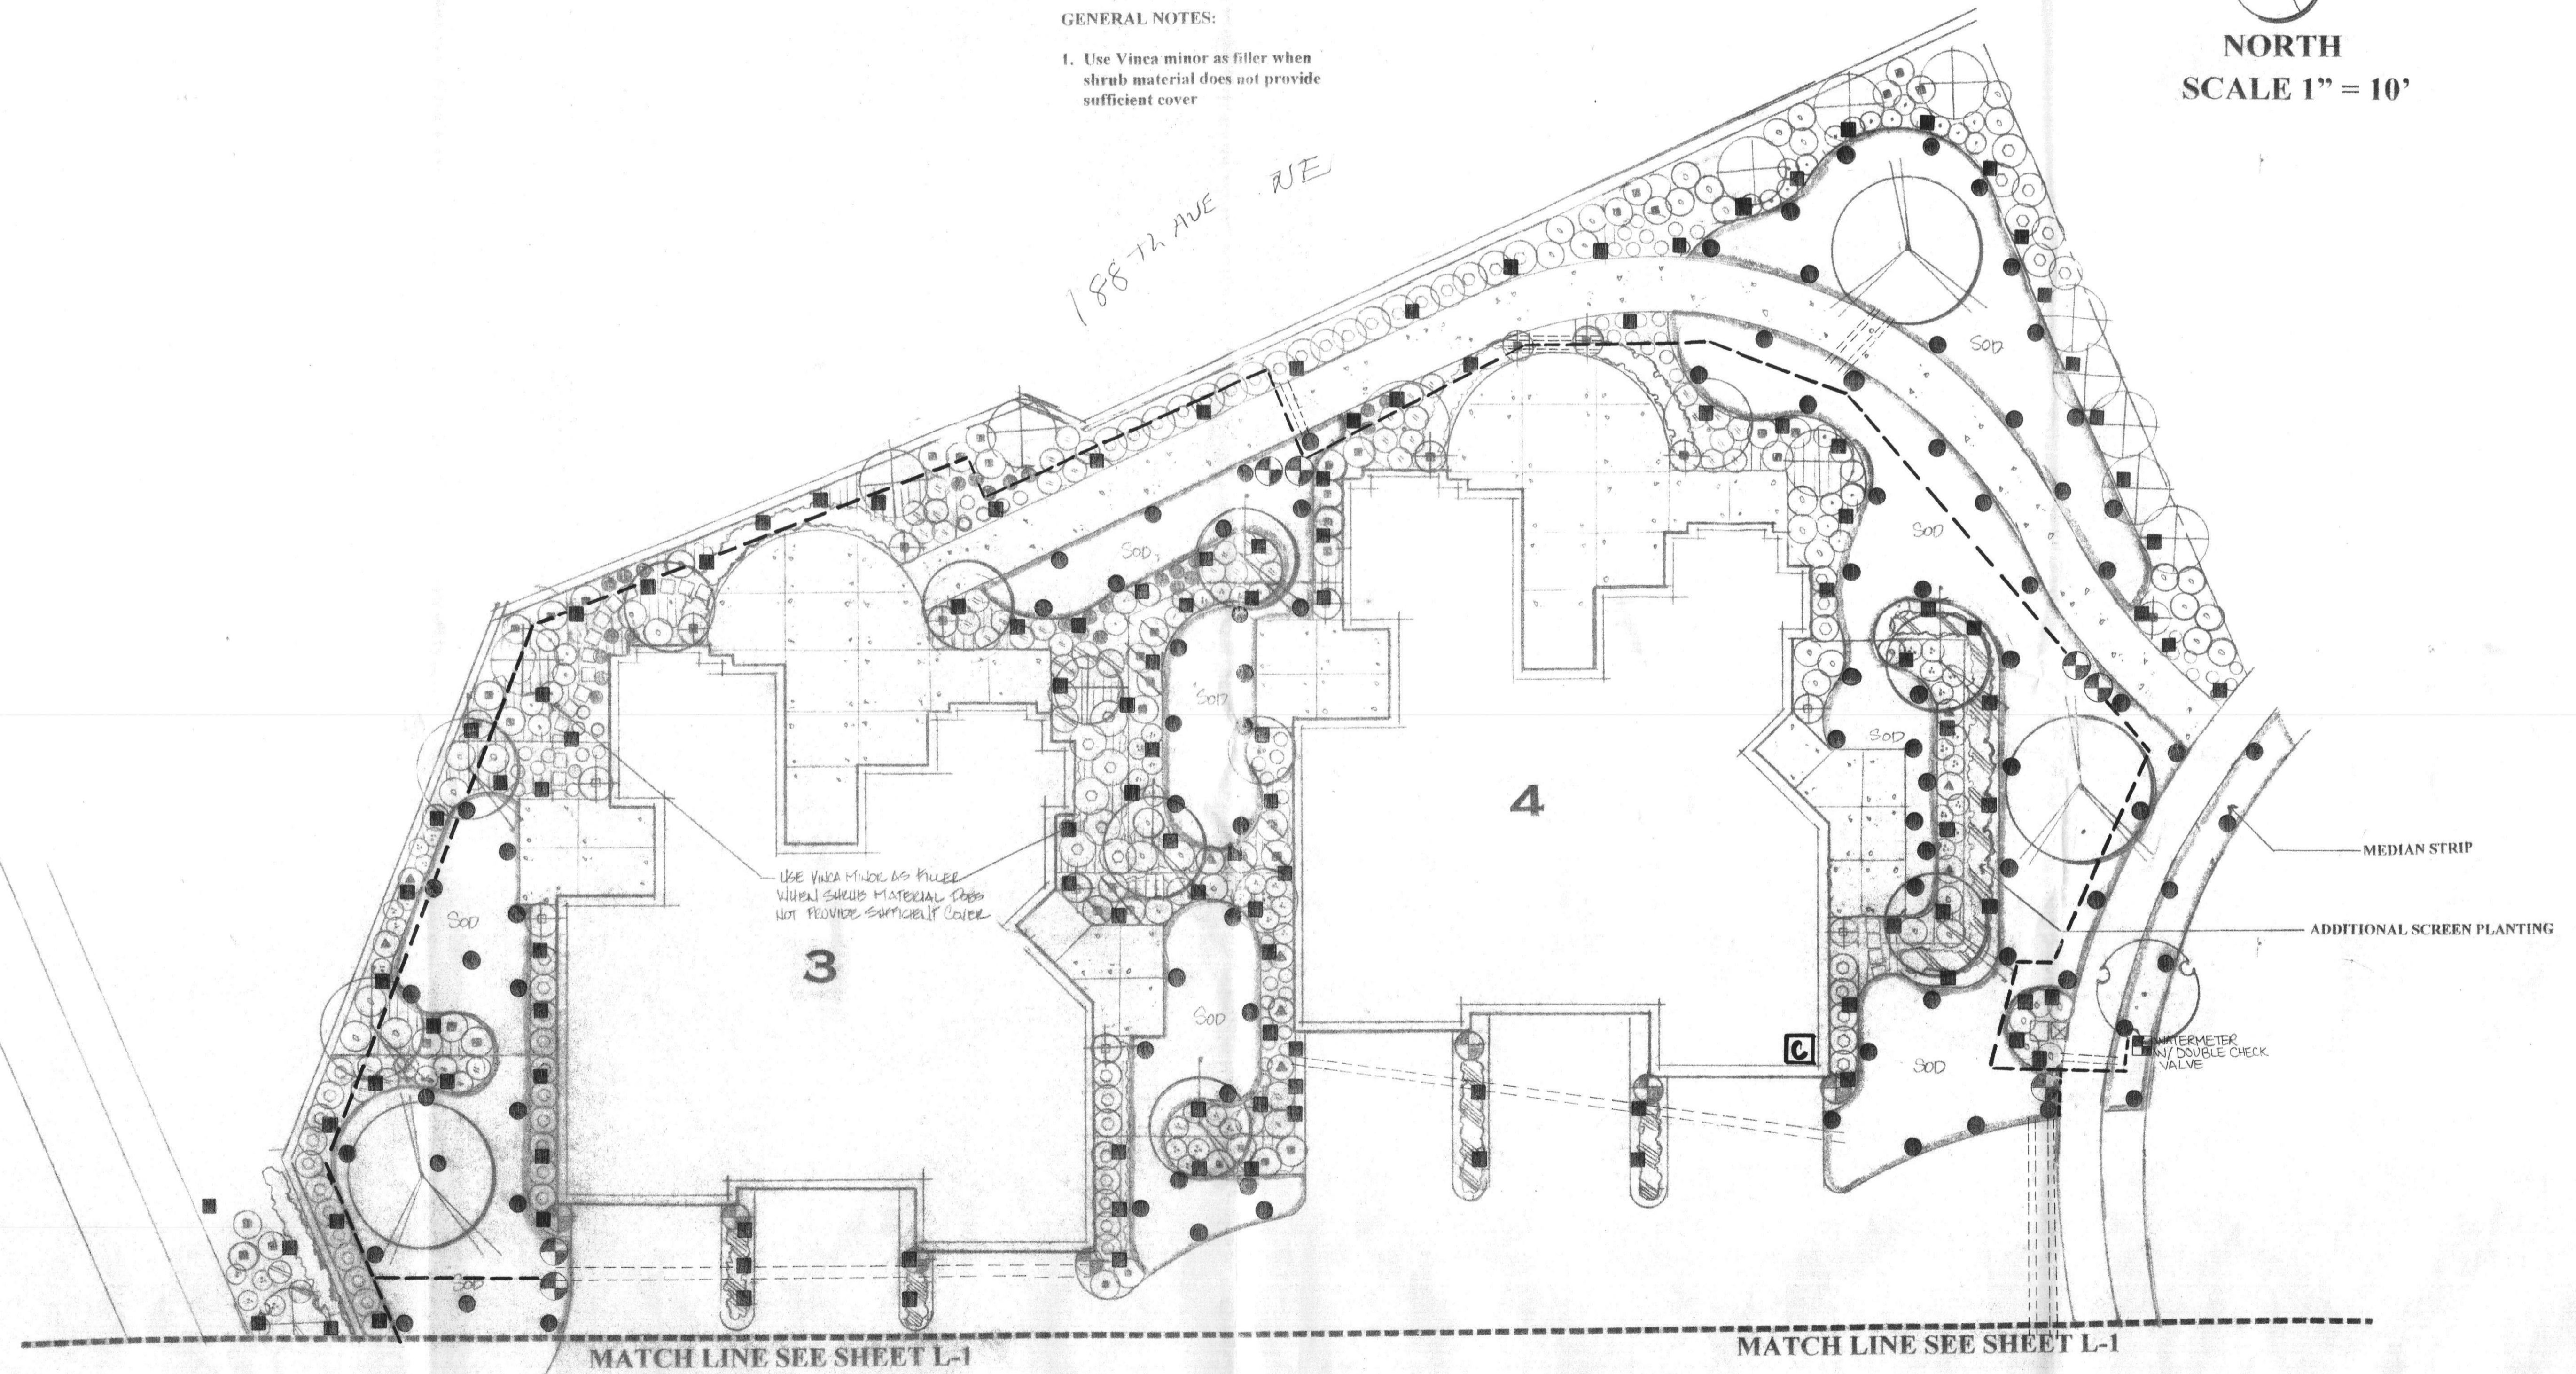

DRAWN BY:
JML

CHECKED

DATE: 10-22-03


REVISED: 11-01-04



CONNER
HOMES

REGISTERED
LANDSCAPE ARCHITECT
Thomas E. Conner
OREGON

WOODBRIDGE
TOWNHOMES

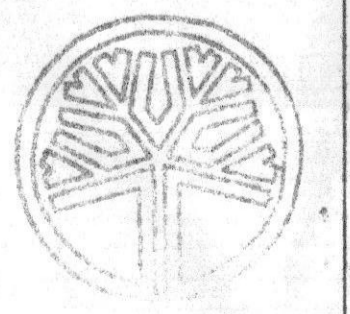

WILLIAM A. BROWN
REGISTERED
LANDSCAPE ARCHITECT

WILLIAM A. BROWN
CERTIFICATE NO. 501

©TUTKO LANDSCAPING & NURSERY, INC.

L-2


LEGEND			
SYMBOL	DESCRIPTION	QTY	SIZE
TREES			
	Acer rubrum/Red sweet Maple	4	2" Cal
	Prunus caroliniana/Thunderbolt Plum	7	2" Cal
	Quercus alba/White Oak	9	6-7"
	Thuja occidentalis/Blue Cedar	1	10-12"
	Pyrus calleryana/Chandler Pear	4	2" Cal
	Syrax japonica/Japanese Snowball	3	2" Cal
SHRUBS			
	Prunus lauro/Starburst Laurel	50	24-30"
	Thuja occ./Emerald Green	8	6"
	Cornus alba/Variagated dogwood	25	5 Gal.
	Berberis th./Roseglow barberry	48	2 gal.
	Philadelphus/Flora	18	5 Gal.
	Rhododendron/Red-tide-dragon	15	5 Gal.
	Nandina/Flame Passion Nandina	28	5 Gal.
	Carex/Variagated Grass	35	1 Gal.
	Prunus lauro/Otto Luyken Laurel	8	5 Gal.
	Large Grass 1	5	4-5"
	Large Grass 2	5	4-5"
	Erica/Heather	32	1 Gal.
	Hydrangea/Hydrangeas	5	8 Gal.
	Phlox/Blue Star Phlox	4	5 Gal.
	Camellia/Camellia	4	5 Gal.
GROUND COVERS			
	Vicia minor/Vicia	45	1 Gal.

Woodbridge (Bldg 5 & 6) rev.
Landscape Plan
3/28/03
TUTKO Landscaping & Nursery Inc.

Option #1			
	Thuja occ./Emerald Green	80	6"
Option #2			
	Street Trees	8	2" Cal.

BUILDING 5 & 6 LANDSCAPE PLAN

SCALE 1" = 10'

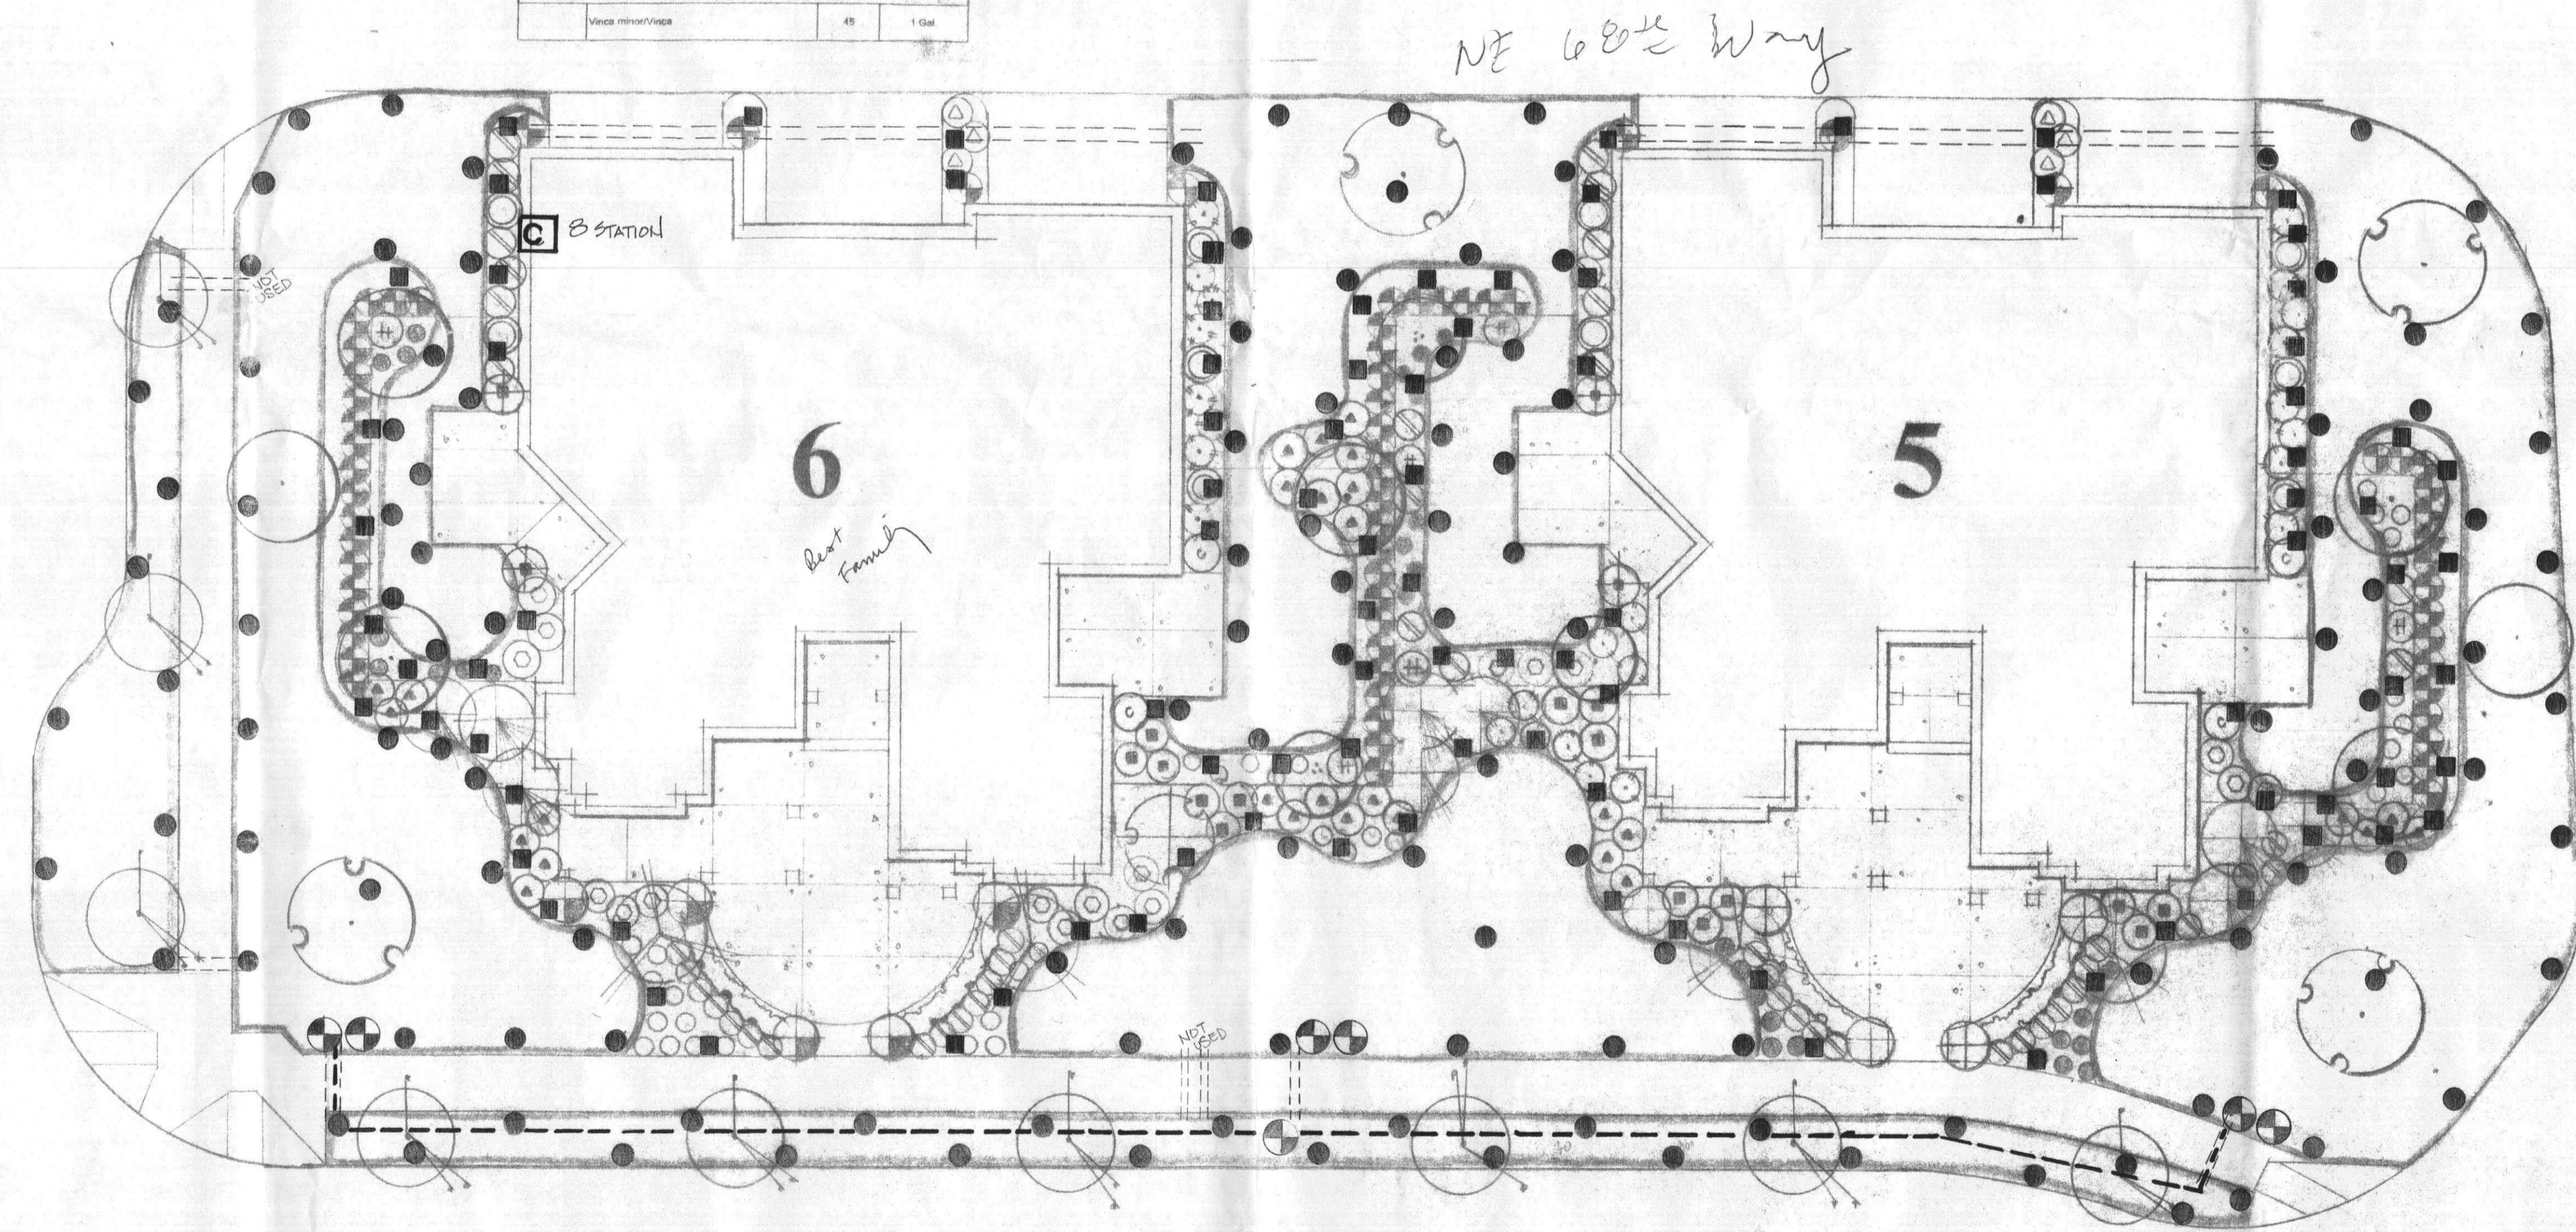

DRAWN BY: _____
CHECKED: _____

DATE: _____
REVISED: _____



WOODBRIDGE TOWNHOMES
CONNER HOMES

L-3

LEGEND			
SYMBOL	DESCRIPTION	QTY	SIZE
TREES			
	Acer rubrum/Red sunset Maple	5	2" Cal
	Prunus cerasifera/Thunderbolt Plum	4	2" Cal
	Abies Inzeriti/Fraser Fir	6	6"
	Cedar/Cedar	3	10-12"
	Pinus calleryana/Chanticleer Pear	4	2" Cal
	Glyxax japonicus/Japanese Snowbell	4	2" Cal

Woodbridge TH (bldg 7 & 8) R

Landscape Plan
10/3/03



SHRUBS		
	Prunus laur./Shiloh Laurel	50 24-30"
	Thuja occ./Emerald Green	6 6"
	Gomera alba/Virgated Redwing Dogwood	21 5 Gal.
	Barberis (Buffsaglow Barberis)	42 2 Gal.
	Viburnum davidsoniae	20 5 Gal.
	Nandina/Pink Passion Nandina	17 5 Gal.
	Nandina/Gulfstream Nandina	27 5 Gal.
	Prunus laur./Ott Luyken Laurel	9 5 Gal.
	Rhododendron/Anahuschia	21 5 Gal.
	Camelia/Camella	4 5 Gal.
	Phormium tenax/New Zealand Flax	4 5 Gal.
	Large Grass	9 4.5"
	Erica carnea/Heather	34 1 Gal.
	Carex/Virgated Grass	34 1 Gal.
GROUND COVERS		
	Vinca minor/Dwarf Periwinkle	30 1 Gal.

BUILDINGS 7 & 8

SCALE 1" = 10'-0"


Option #1			
	Thuja occ./Emerald Green	53	6"

Option #2			
	Acer rubrum/Red sunset Maple	8	2" Cal.

Woodbridge TH (bldg 7 & 8) R

Woodbridge TH (bldg 7 & 8) R

Landscape Plan

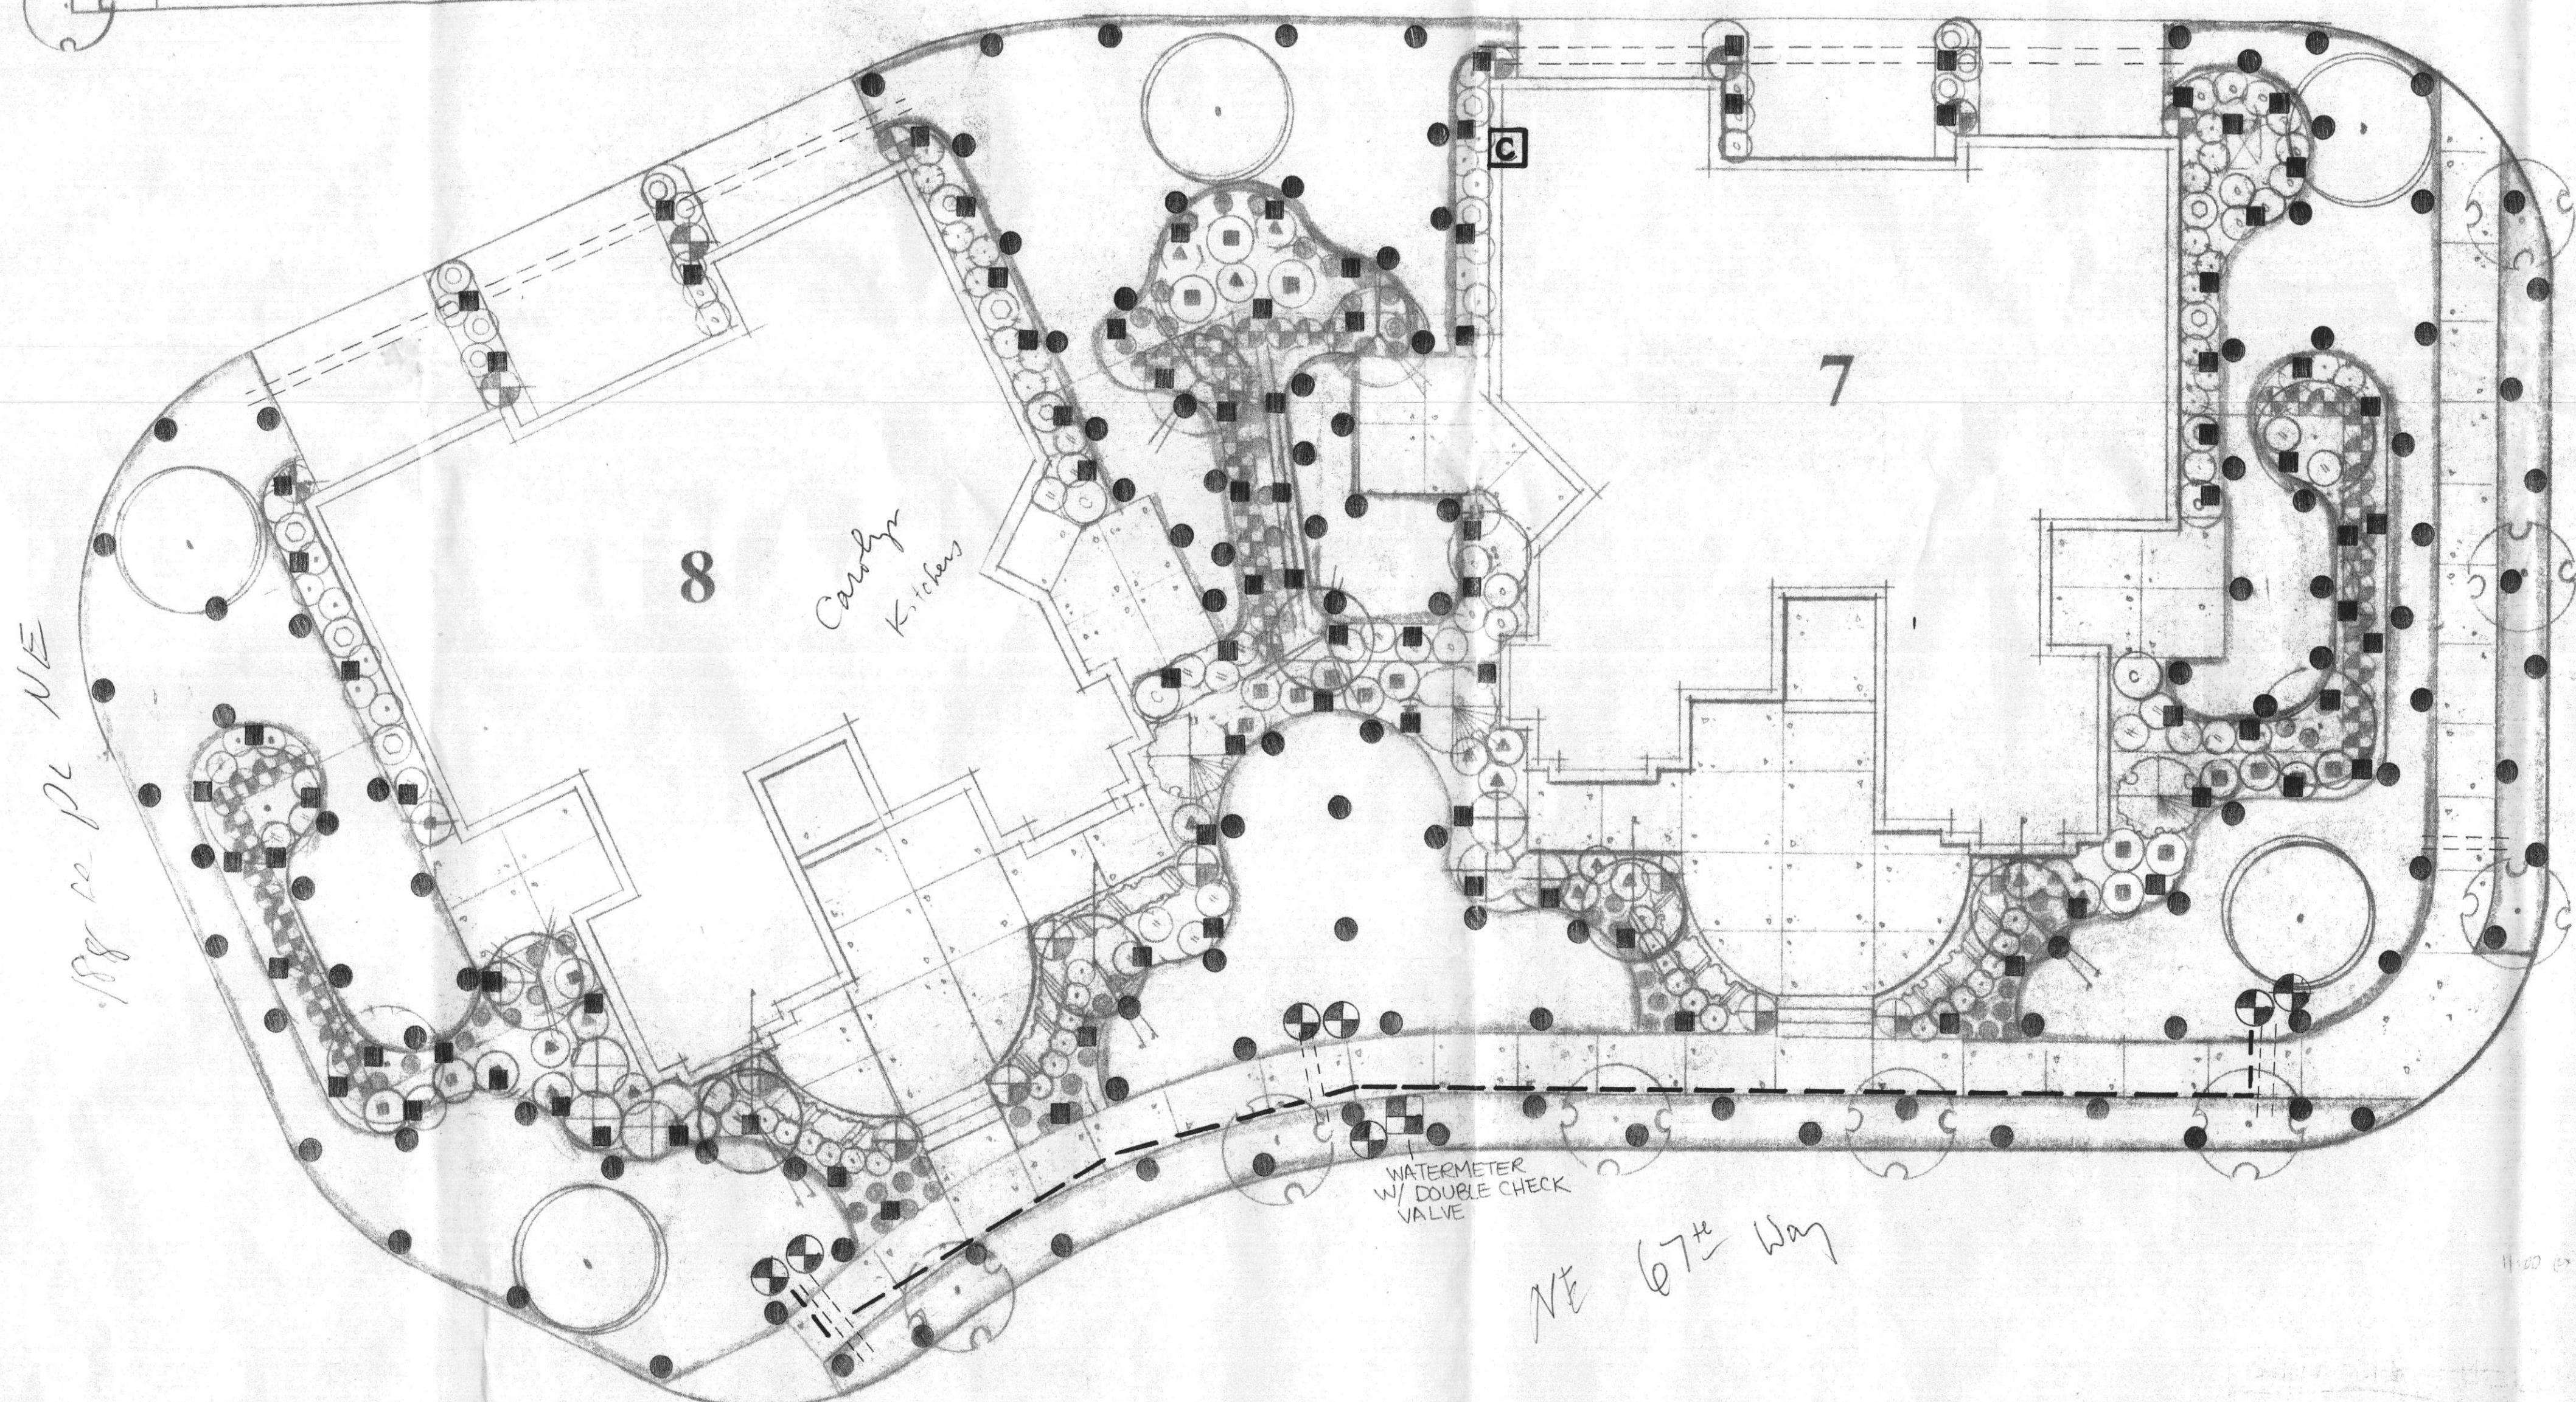

DRAWN BY: _____
CHECKED: _____

DATE: _____
REVISED: _____



WOODBRIDGE TOWNHOMES
CONNER HOMES

L-4